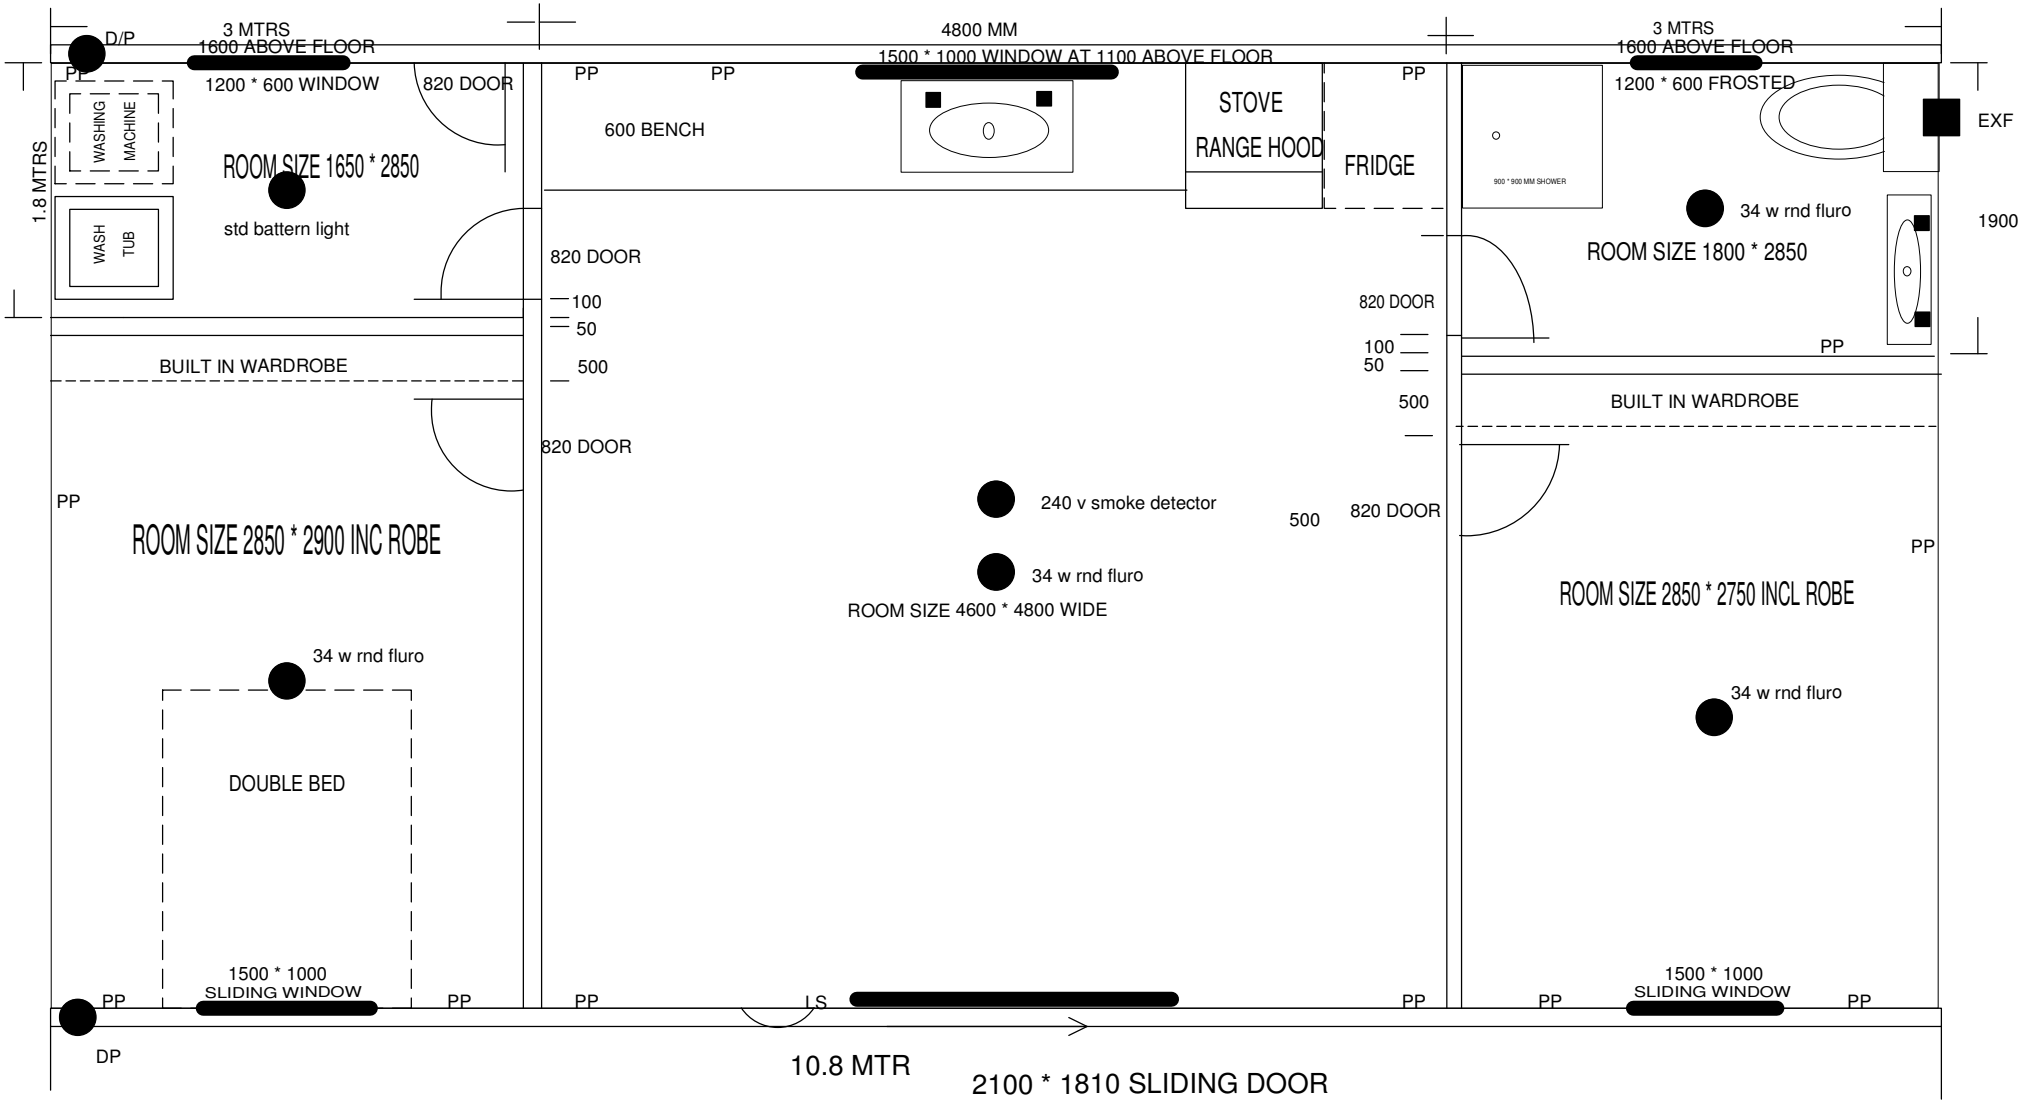

Lamont family trust t/as ANOTHER ROOM
P.O BOX 647 MORUYA NSW 2537
PHONE/ FAX 02 44 740393 MOB 0428 632247
EMAIL SALES@ANOTHERROOM.COM.AU

CLIENT:

PROJECT 10.8 * 4.8 MTR 2 BED CABIN			
TITLE			
SCALE N.T.S	DRAWN BY G.L	SHEET OF	DWG No
DATE 7/4/11	CHCKD GL	JOB No	AS BUILT